
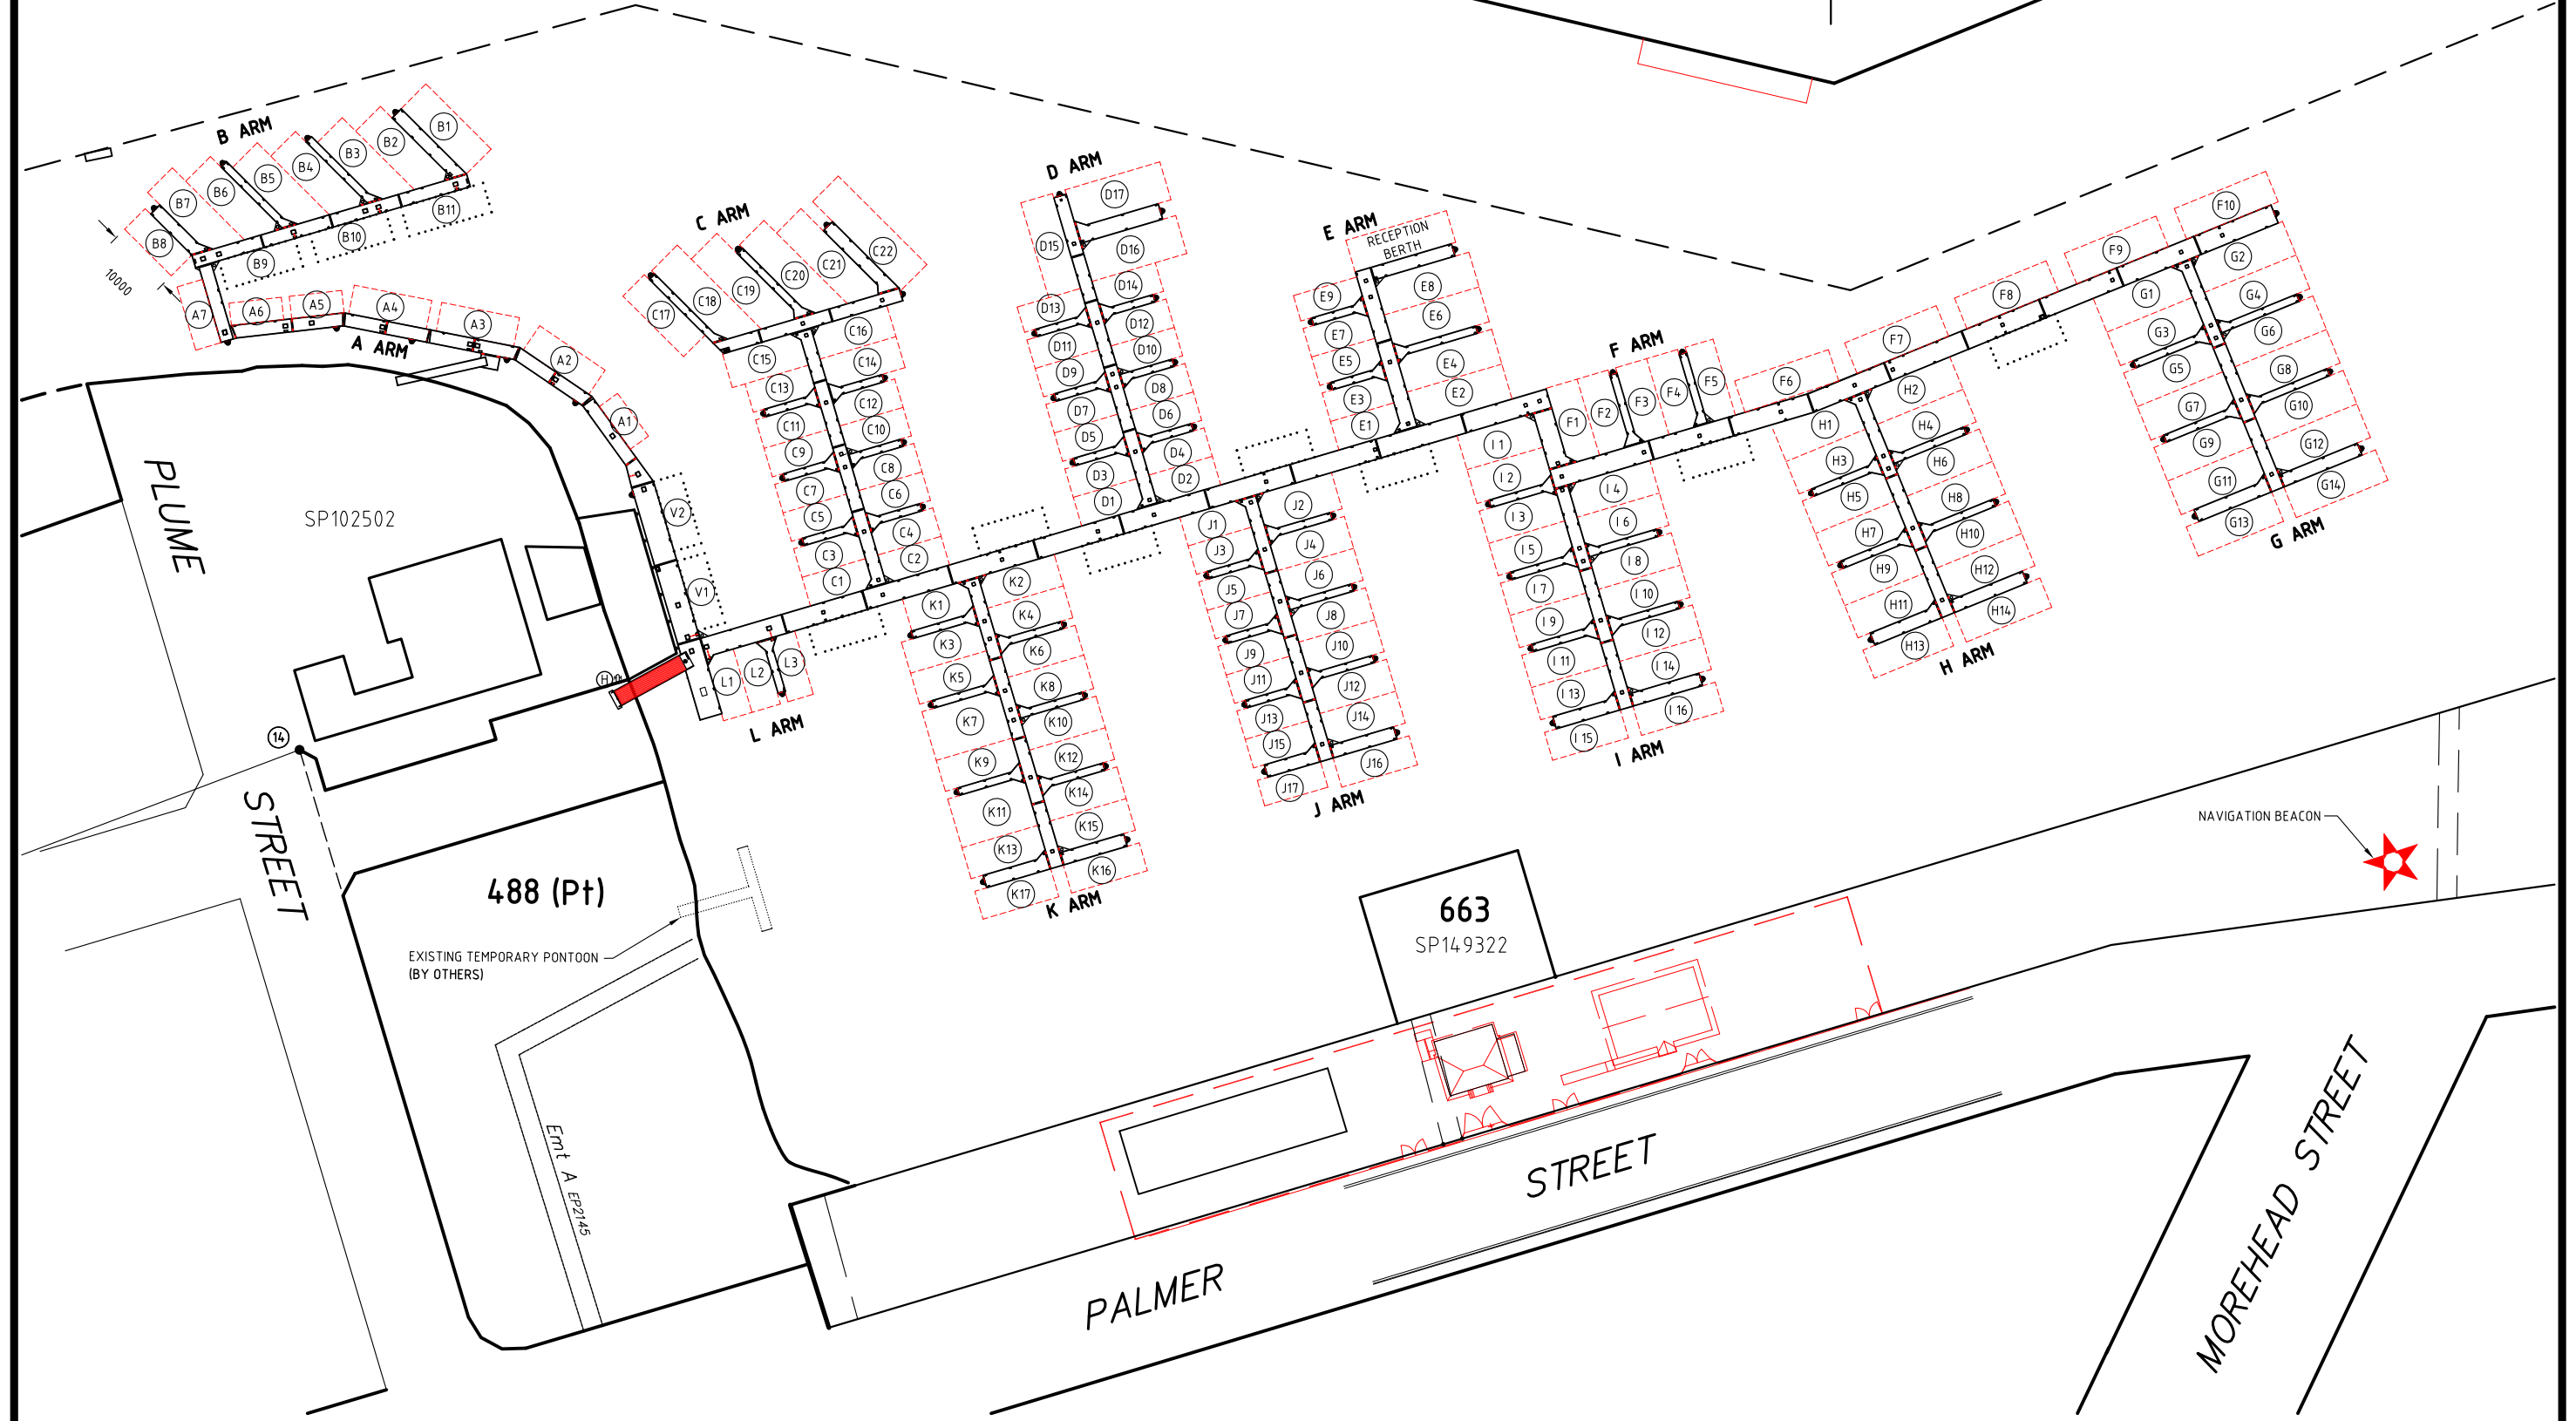


ROSS CREEK

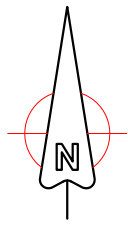

No:	DATE	REVISION

ATLAS MARINE INTERNATIONAL  
TRADING AS  
SUPERIOR JETTIES

COPYRIGHT © 2006 ATLAS MARINE INTERNATIONAL PTY. LTD.  
NO PART OF THIS DOCUMENT MAY BE COPIED, REPRODUCED, STORED  
IN A RETRIEVABLE SYSTEM IN ANY FORM, OR TRANSMITTED BY  
ANY MEANS WITHOUT PRIOR WRITTEN PERMISSION OF ATLAS  
MARINE INTERNATIONAL PTY. LTD.

**SUPERIOR**  
*jetties*

15 Jade Drive Nerang Qld. Australia  
Mail Address: P.O. Box 920 Nerang 4211  
Ph: (07) 55 971933  
Fax: (07) 55 970476  
Email: info@superiorjetties.com

DATE  
19/06/09

DRAWING NO:  
**3459-AC-01**

REVISION NO:

PROJECT  
**PROPOSED MARINA LAYOUT  
AS CONSTRUCTED MARINA LAYOUT**

DRG. TITLE

CLIENT  
**TOWNSVILLE MOTOR BOAT & YACHT CLUB LTD**

ADDRESS  
**PLUME STREET  
TOWNSVILLE**

DRAWN BY: D.G.G. DESIGNED: S.R.B. PAPER SIZE: A3 SCALE: 1:1000 FILE NAME:

**INDICATIVE ONLY**

**SUBJECT TO FINAL  
ENGINEERS  
SPECIFICATIONS  
AND APPROVAL**